

Notice of Discontinuation

Company: KYCON, Inc. 305 Digital Dr. Morgan Hill, CA 95037 USA 408-494-0330

3/6/2023

Re: **EOL**

Part Number: KLDPX-0207-A; KLDPX-0207-B


Please note that the above part numbers are EOL due to worn tooling.

Engineering has approved an alternate part.
Please contact your Kycon Sales Representatives for details.

Alternate part numbers: KLDPX-0207-A-1

KLDPX-0207-B-1

Redline drawing attached

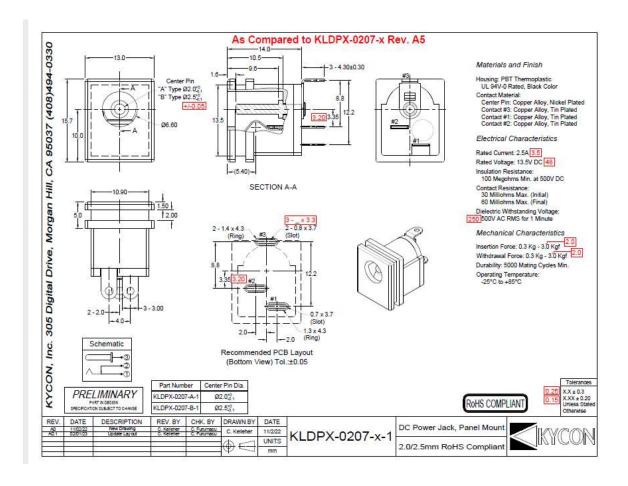

Please contact your Kycon sales representative if you require more information.

Signature:

Name: Jill Scarnecchia

Phone: 408-494-0330